



NOTES:


1. SPECIFIC NOTES ARE CALLED OUT ON INDIVIDUAL DRAWING DETAILS.

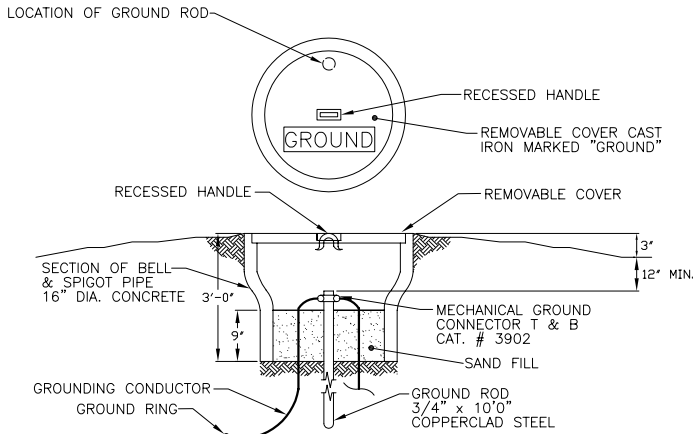


1 GROUNDING TEST STATION DETAIL
E-5

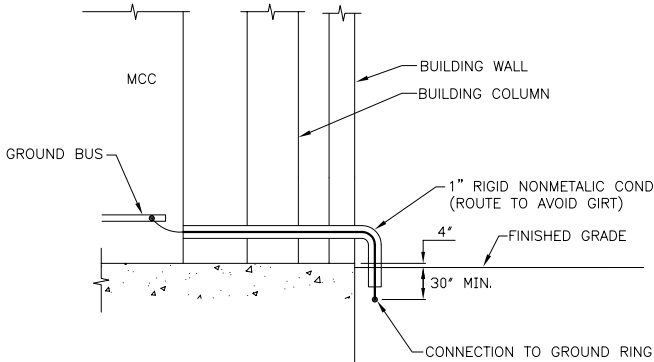



4 MCC OR EQUIPMENT
GROUND CONNECTION
E-5

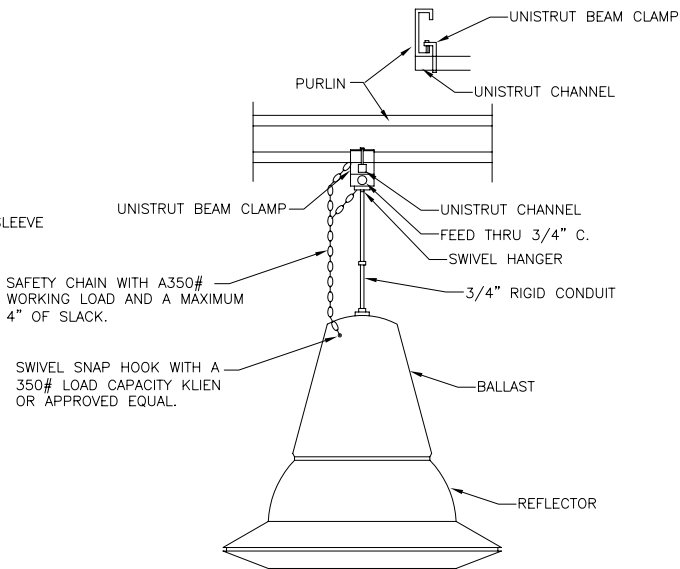


6 FIXTURE TYPE H1 MOUNTING DETAIL
E-5

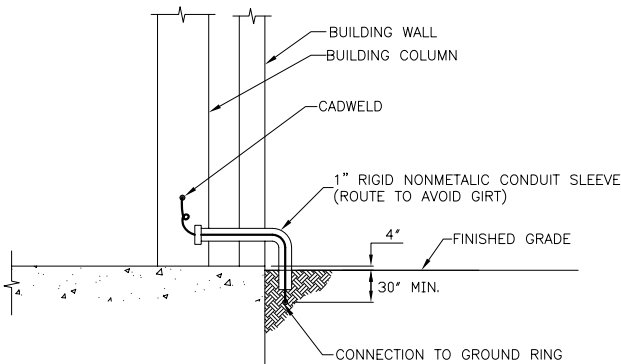


2 STEEL COLUMN OR METAL BUILDING
GROUND CONNECTION
E-5

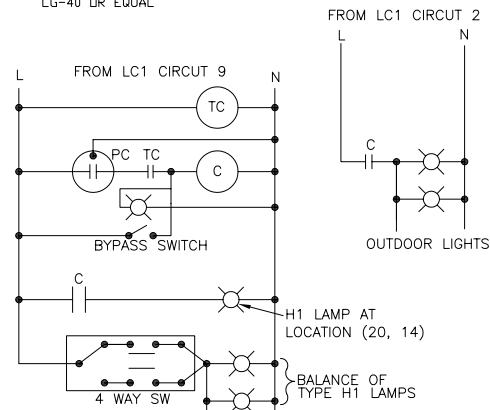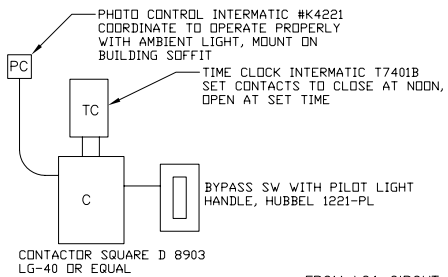


5 PHOTO/TIME CLOCK LIGHTING
CONTROL WIRING DIAGRAM
E-5

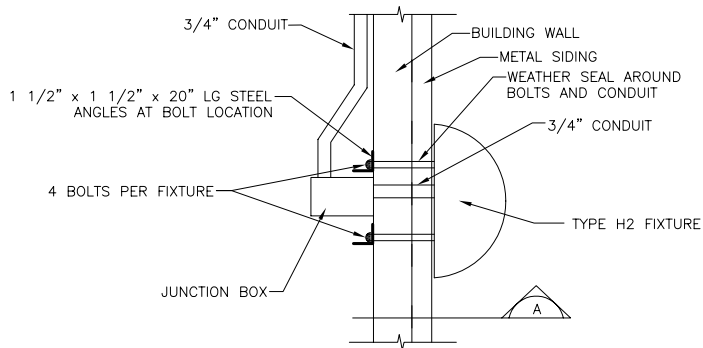

7 FIXTURE TYPE H2 MOUNTING DETAIL
E-5

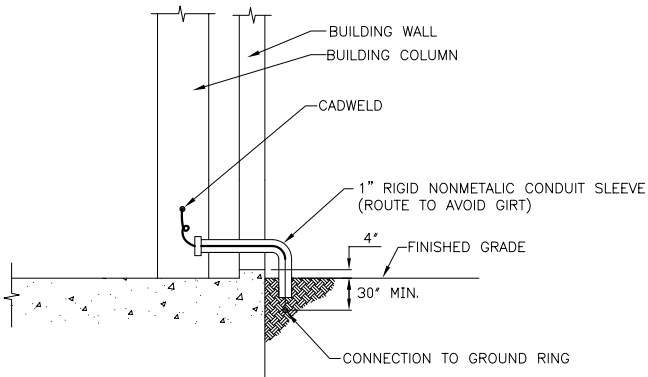

3 STEEL COLUMN OR METAL BUILDING
GROUND CONNECTION
E-5

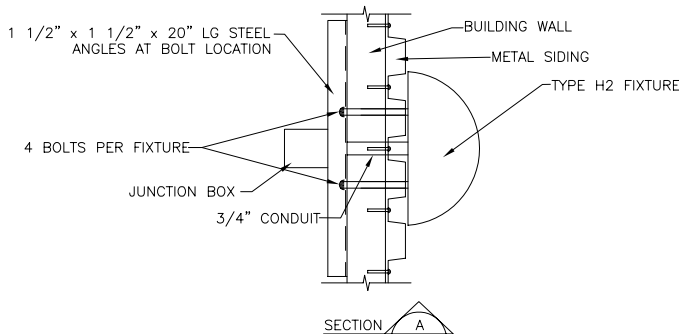

ELECTRICAL DETAILS

PEMACO SUPERFUND SITE
5050 EAST SLAUSON AVENUE
MAYWOOD, CALIFORNIA

PREPARED FOR:
U.S. Environmental
Protection Agency
Region IX
San Francisco, California

PREPARED BY:
JACOB & STEPHEN ASSOCIATES
15375 BARRANCA PARKWAY, SUITE 41-101
BARRANCA, CALIFORNIA 92015
PHONE: (949) 453-1045

SCALE: AS SHOWN

DESIGNED:
DRAWN: DC #BIBP
CHECKED: J.W.

APPROVED

AS BUILTS

DATE: 06/13/2007

DRAWING

E-5

AS-BUILT